


LINDEN STREET

PIERCE STREET

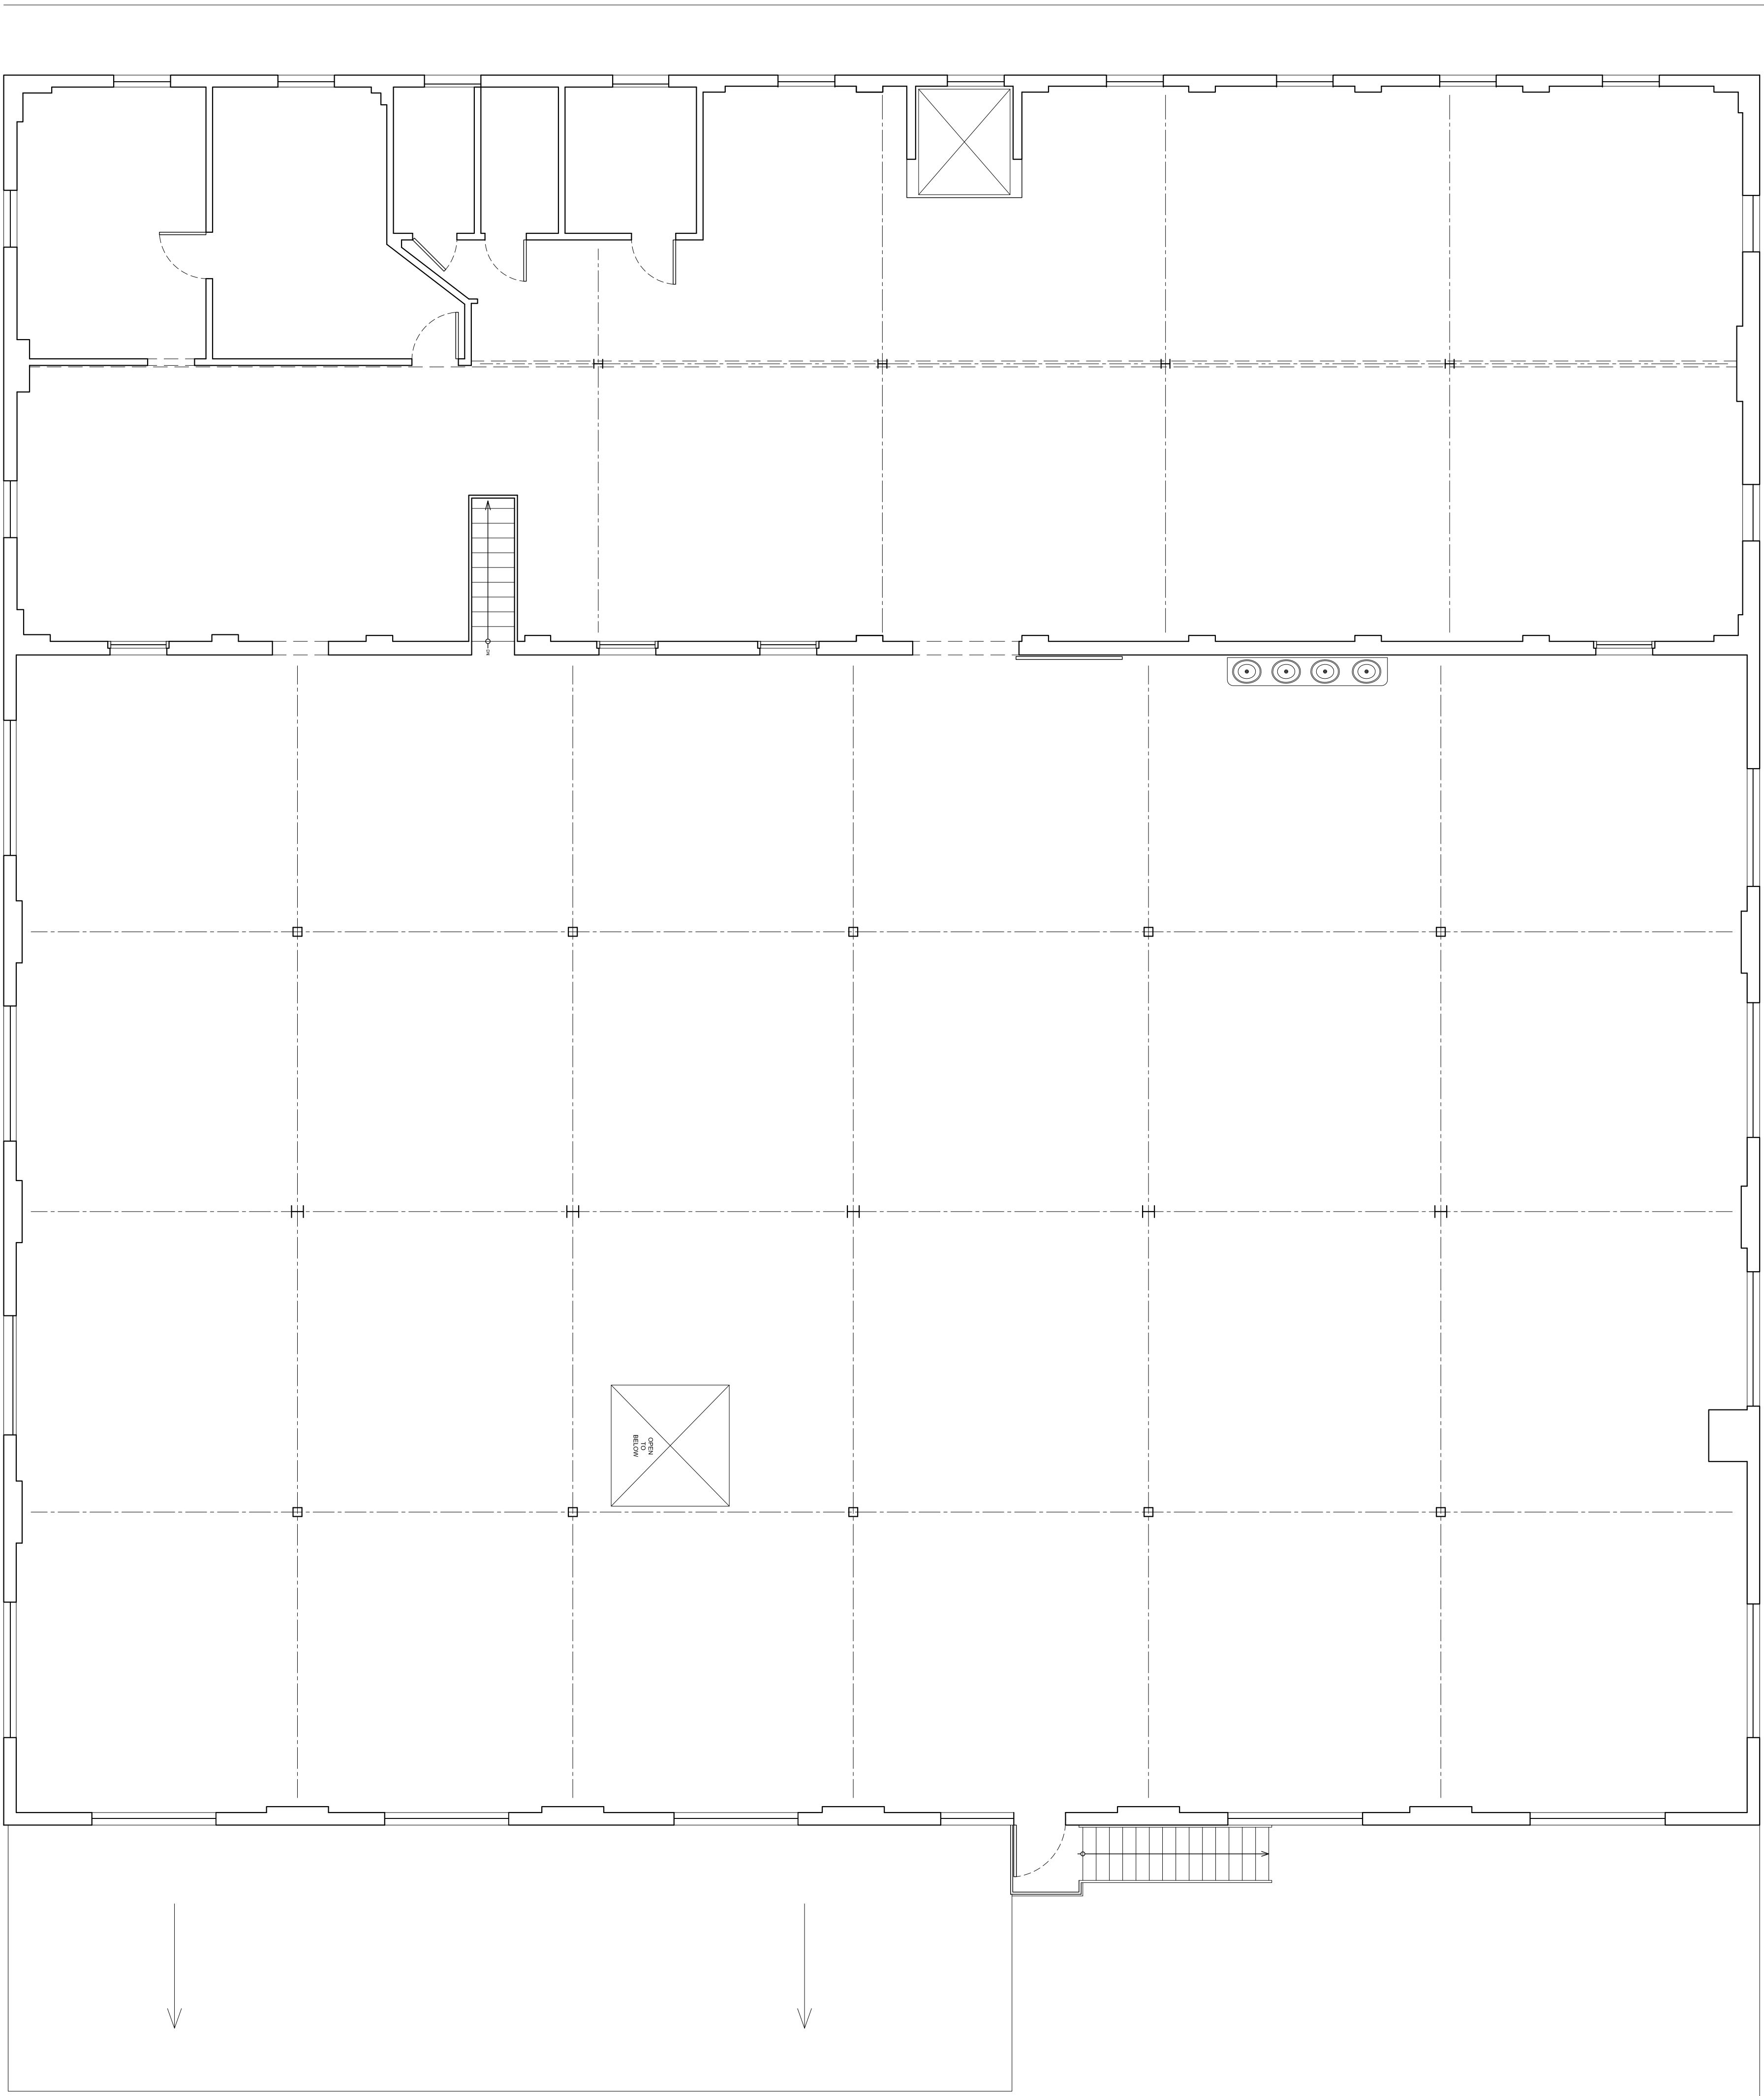

SECOND FLOOR PLAN  
SCALE: 3/8" = 1'-0"


SHEET NUMBER

SHEET TITLE: *Second Floor Plan*

DATE:	SCALE:	DESCRIPTION:
04.05.2010	3/8" = 1'-0"	As-Built
04.08.2010		As-Built

R.E.P Industries Inc.  
Existing Floor Plan

Pierce & Linden St.  
Lansdale, PA 19446


  
**CONSTANCE LEZENBY ARCHITECTS**
  
 GREEN DESIGN • CHURCHES
   
 COMMERCIAL • RESIDENTIAL
   
 ACCESSIBILITY • MASTER PLANS
   
 T: 215.393.9192
   
 F: 215.393.3637
   
 C: 267.664.3721
   
 E: LEZENBY@AOL.COM
   
 724 DERSTINE AVENUE
   
 LANSDALE, PA 19446
   
[www.lezenbyarchitects.com](http://www.lezenbyarchitects.com)

