


LINDEN STREET

PIERCE STREET

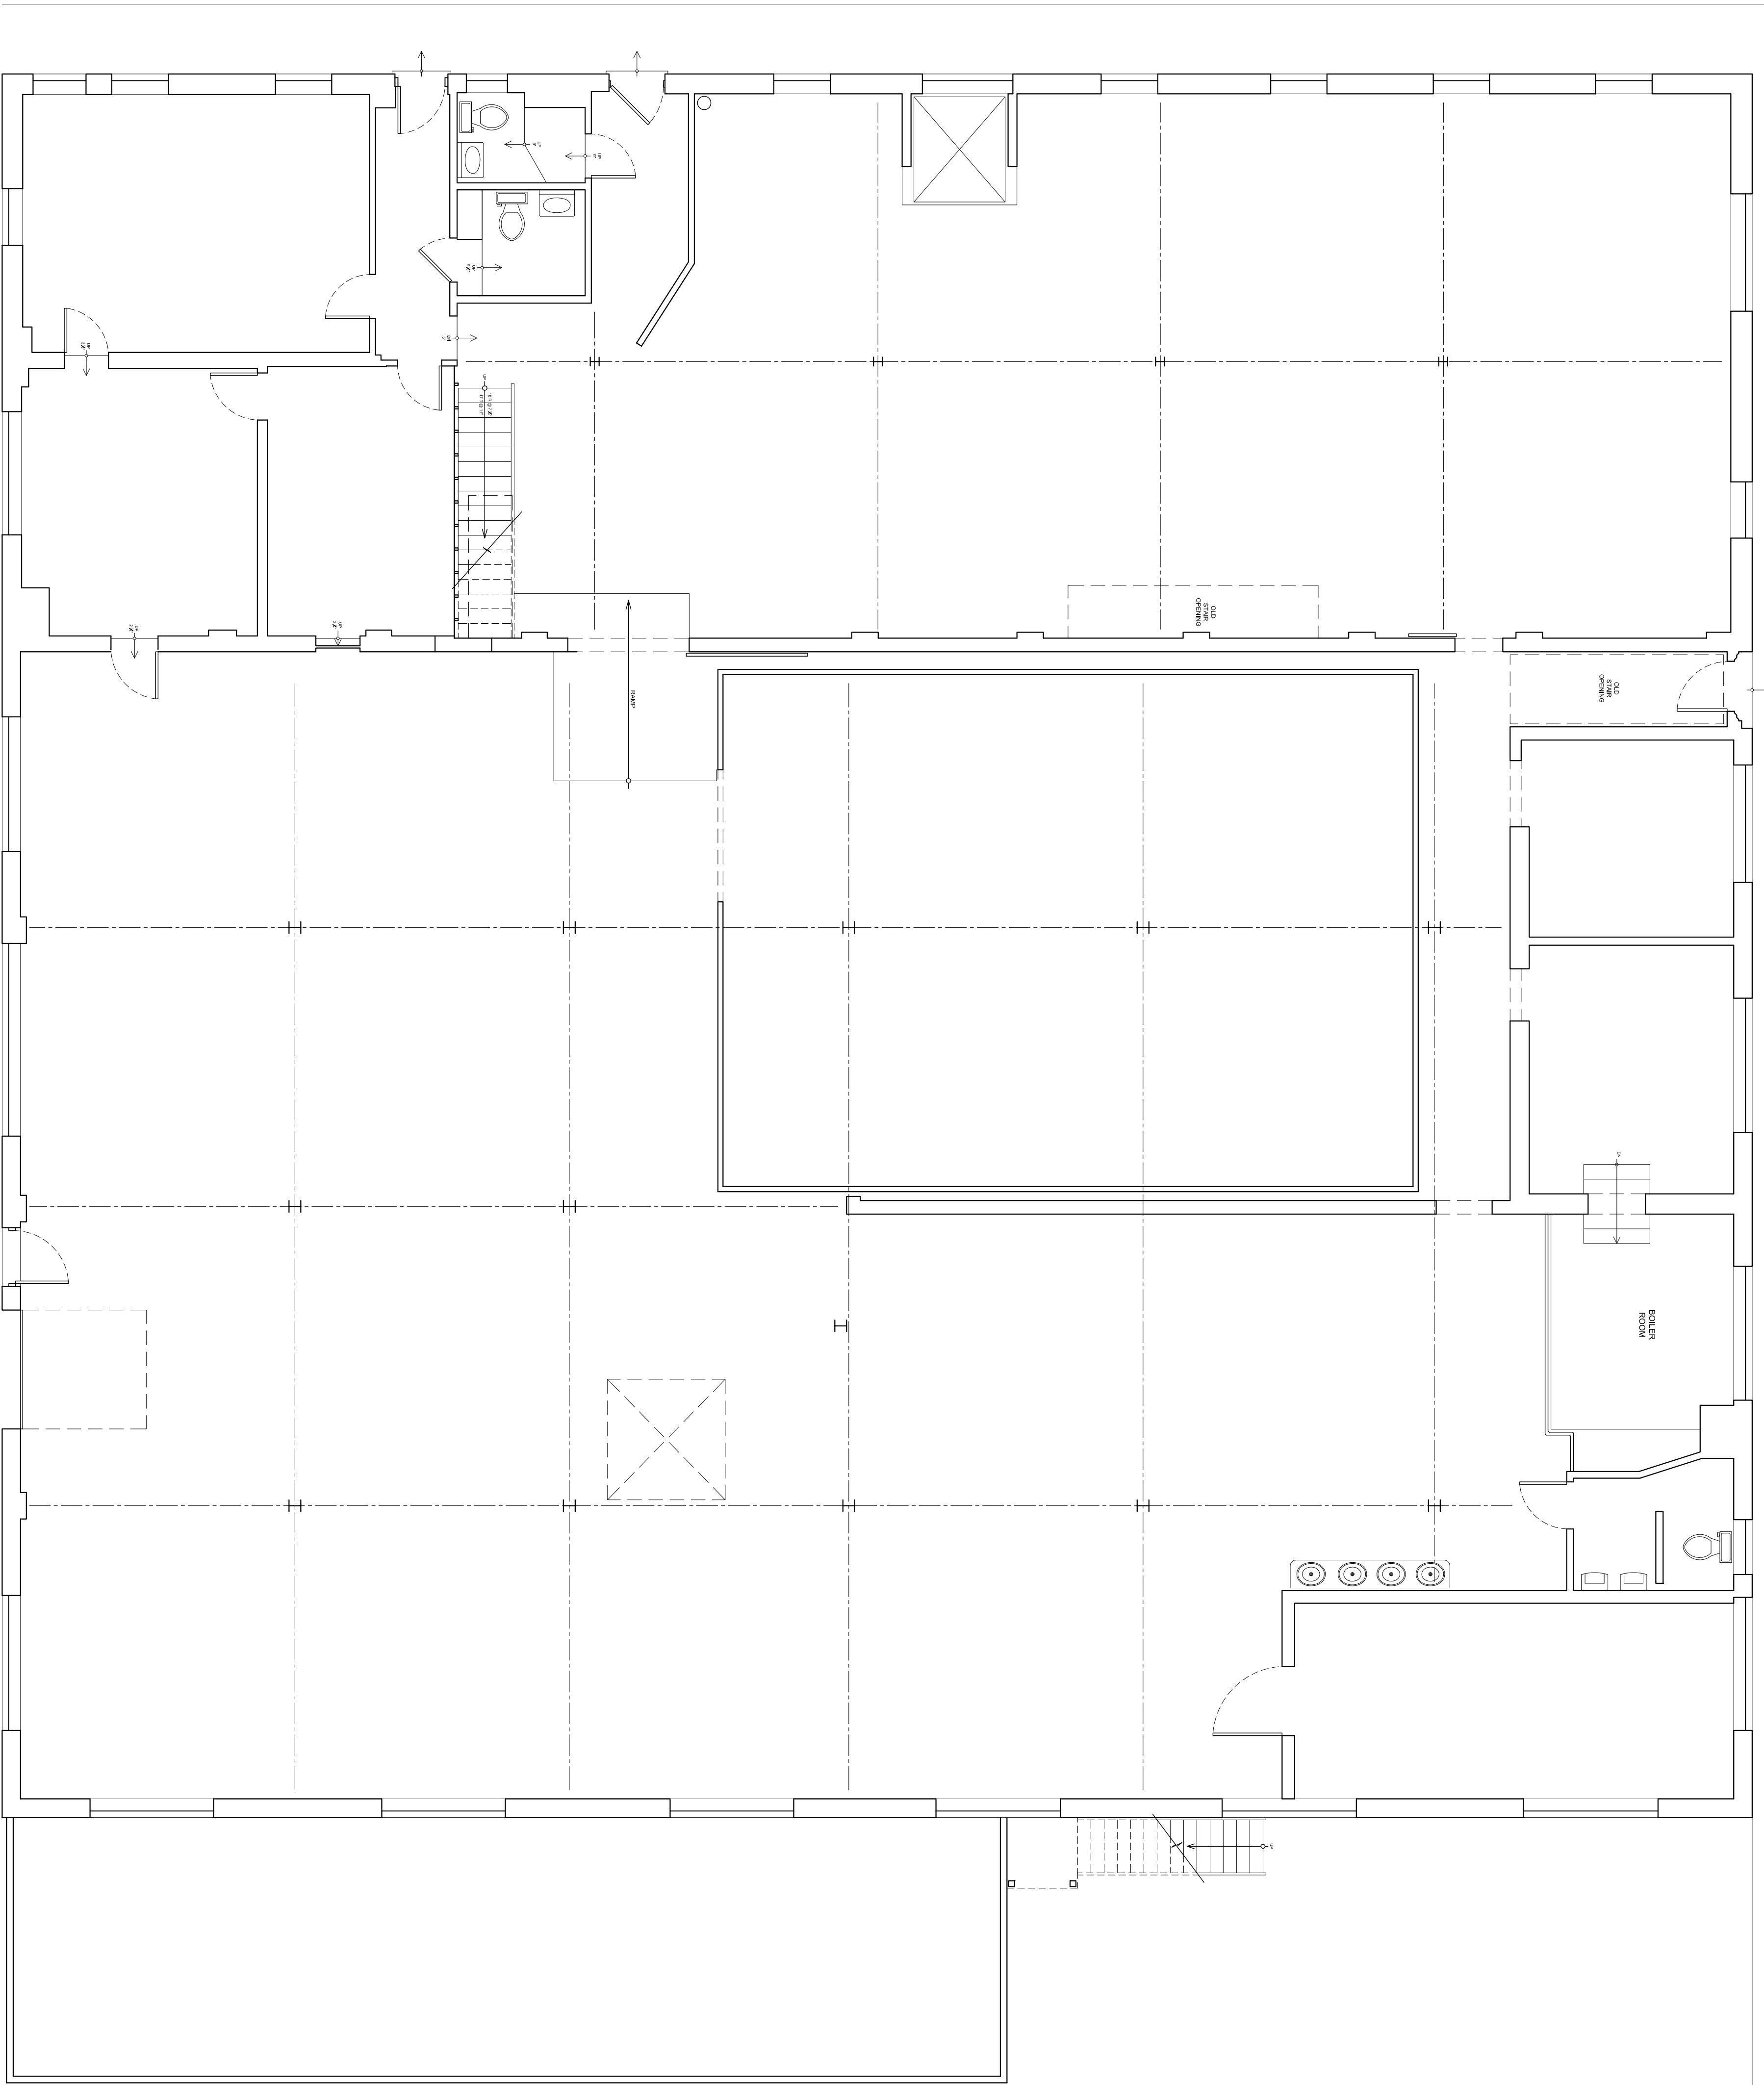

FIRST FLOOR PLAN  
 SCALE: 3/8" = 1'-0"

SHEET NUMBER

SHEET TITLE: *First Floor Plan*

DATE:	REVISIONS	DESCRIPTION:
04.05.2010	As-Built	
04.08.2010	As-Built	

SCALE: 3/8" = 1'-0"

R.E.P Industries Inc.  
Existing Floor Plan

Pierce & Linden St.  
Lansdale, PA 19446

  
**CONSTANCE LEZENBACH ARCHITECTS**  
 GREEN DESIGN • CHURCHES  
 COMMERCIAL • RESIDENTIAL  
 ACCESSIBILITY • HISTORIC PLANS  
 T: 215.393.9192  
 F: 215.393.3637  
 C: 267.666.3721  
 E: LEZENB@AOL.COM  
 724 DERSTINE AVENUE  
 LANSDALE, PA 19446  
 www.lezenbacharchitects.com

