



FIRST FLOOR
1,713 SF

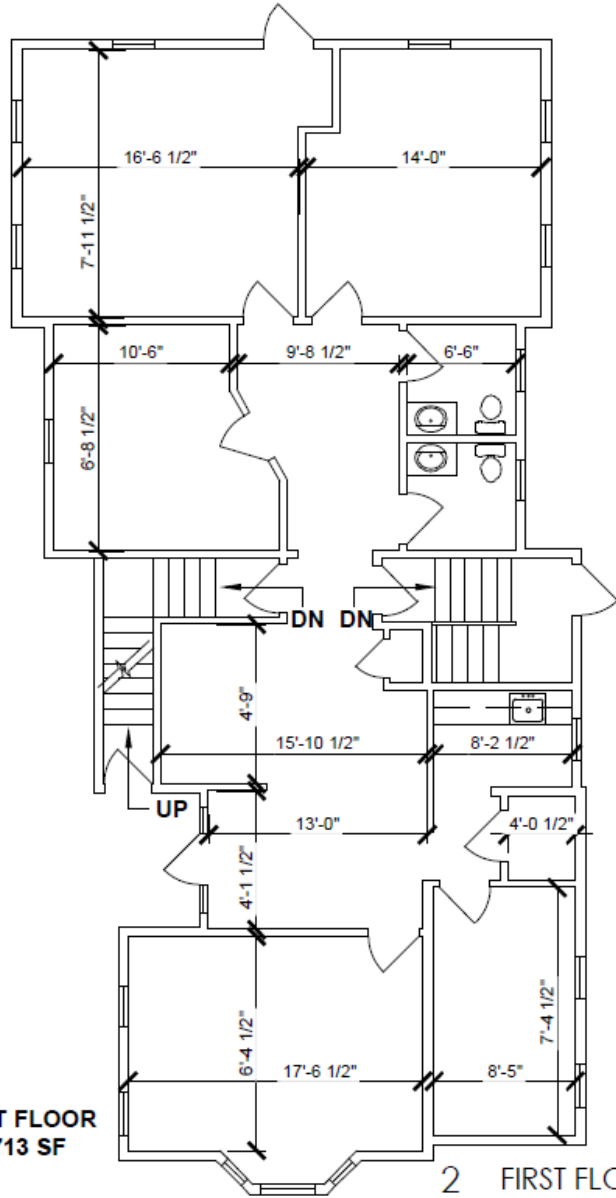

2 FIRST FLOOR PLAN

A1.0 1/8" = 1'-0"

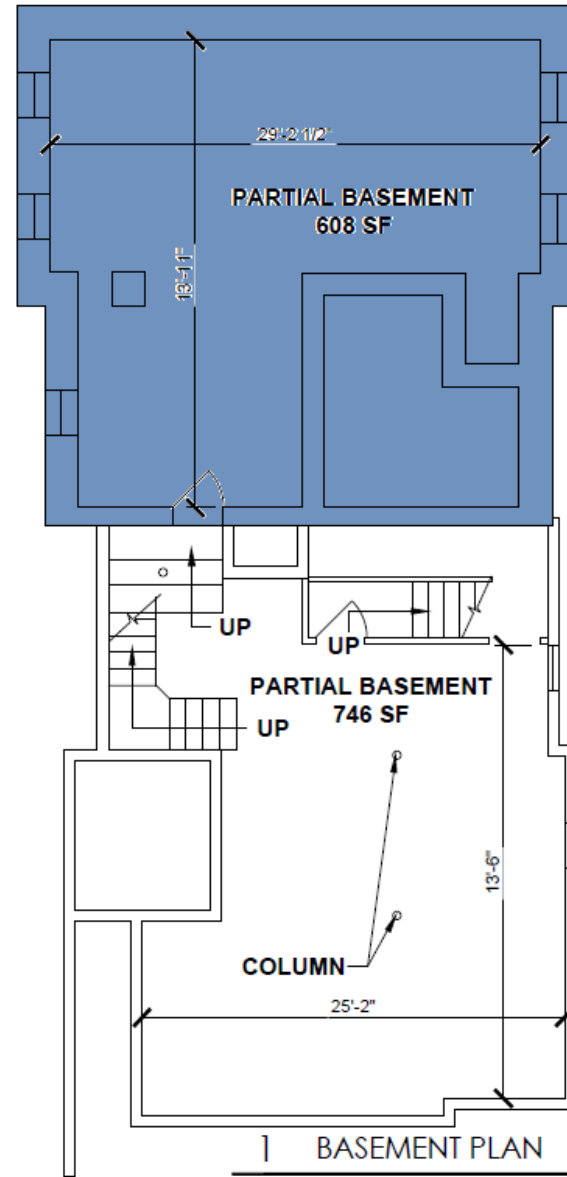

1 BASEMENT PLAN

A1.0 1/8" = 1'-0"

TITLE FLOOR PLANS

DWG NO.

A1.0

Date: 03/20/2020

Scale: AS NOTED

Name: SAM

joseph/rominski/architecture
PITTSBURGH OFFICE
116 SUMMIT AVE., SUITE A
FORT WASHINGTON, PA 19034
PH: 267.992.2345

AS-BUILT PLAN

801 BETHLEHEM PIKE
ERDENHEIM, PA 19038